
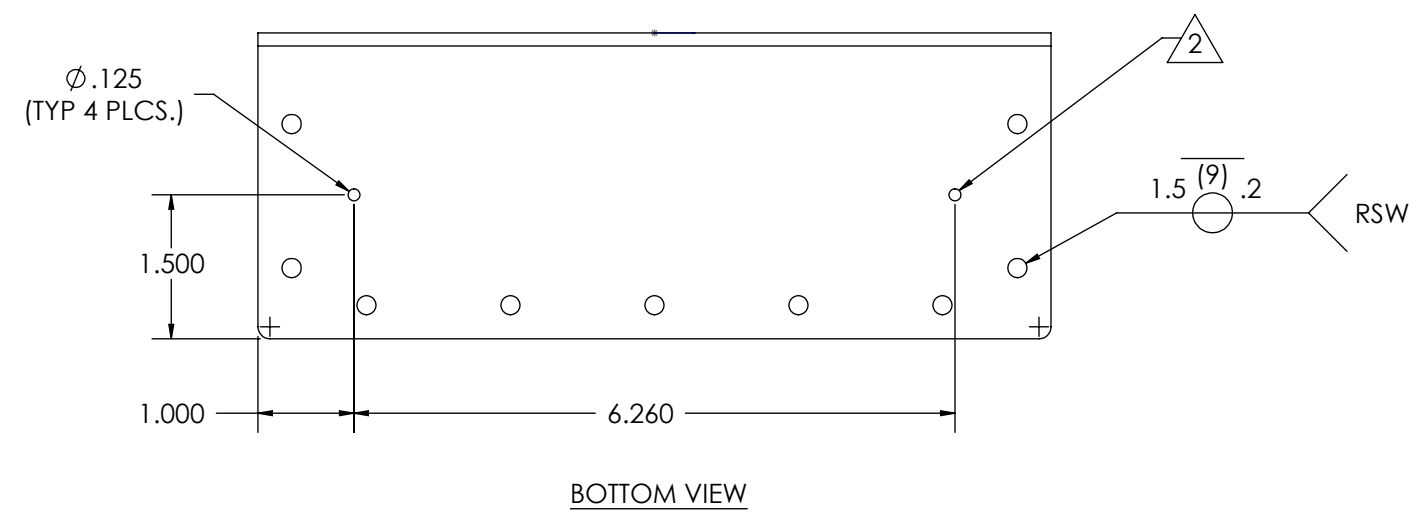
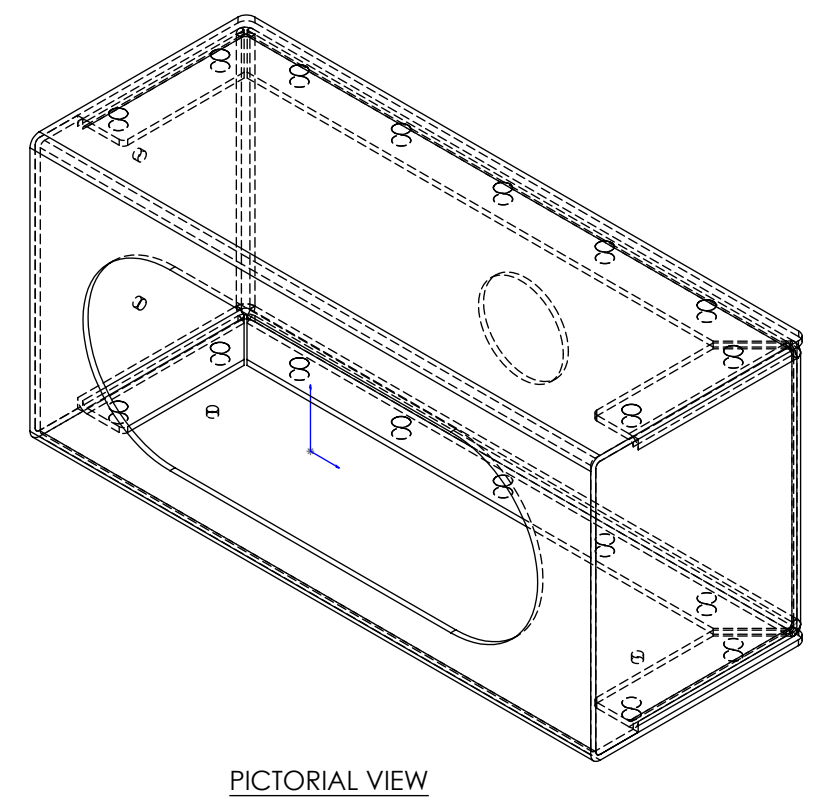
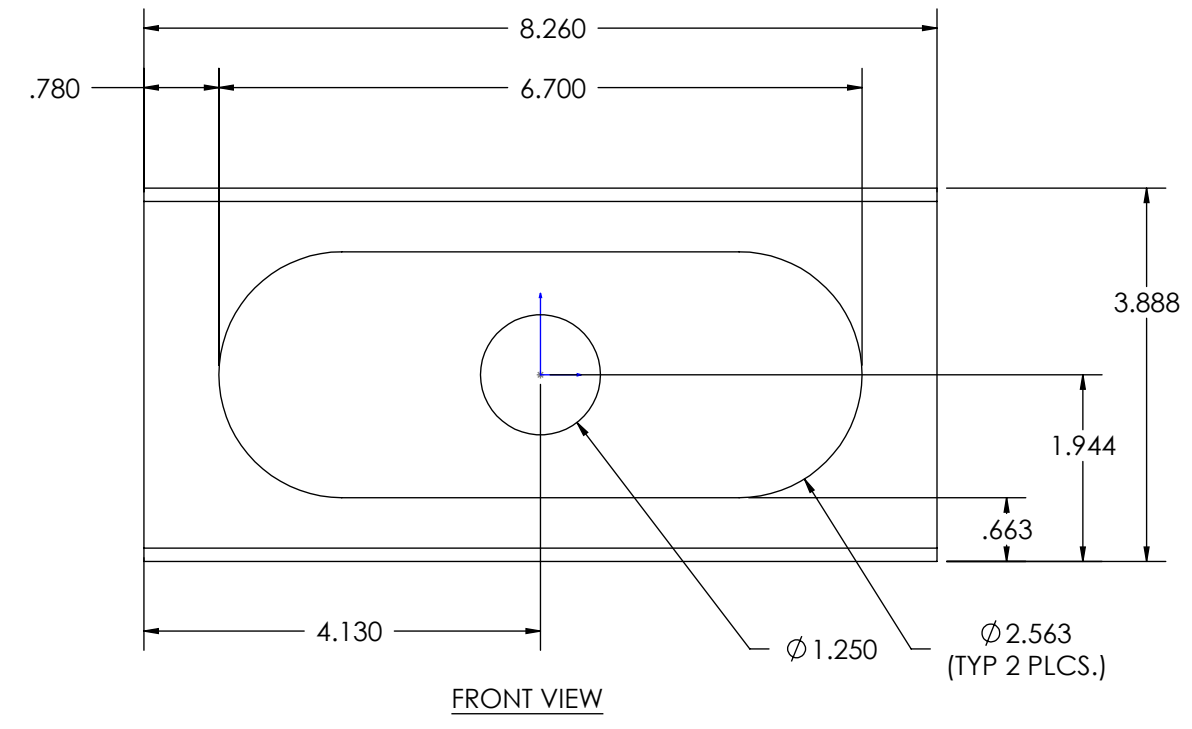


REVISION HISTORY		
REV.	DESCRIPTION	DATE
A	INITIAL RELEASE	4-1-96
B	TOLS. +/- 0.010 O'ALL. FIXED DIM ON OVAL	5-14-96
C	MODELED IN SW. AS BUILT, PER CR# 1292	2003-01-08

- NOTES:
1. MAKE DRAIN HOLES SYMMETRICAL.
  2. DRAIN HOLES LOCATED ON LEFT AND BOTTOM SIDES ONLY.
  3. TOLERANCES ARE +/- 0.050 UNLESS OTHERWISE NOTED IN DRAWING OR MODEL.
  4. DIMENSIONS IN INCHES.

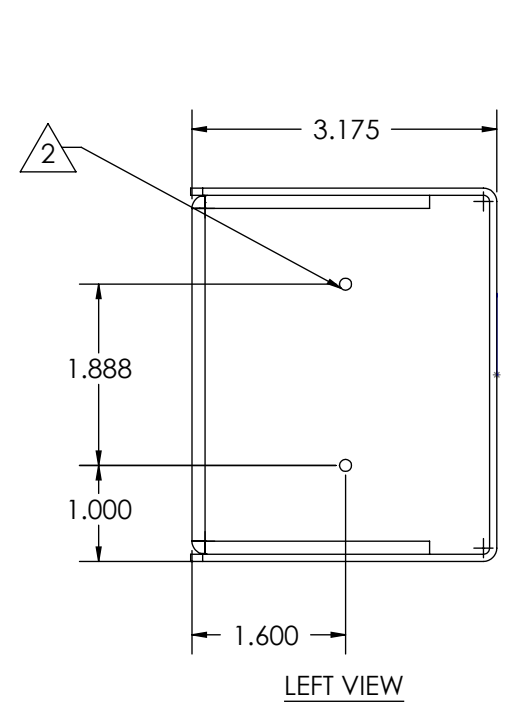

STEEL, 14GA. (0.0747)		BLACK POWDER COAT	
MATERIAL		COLOR	
STEEL, 14GA. (0.0747)		MASS (LBS)	PART VOLUME (IN3)
		2.78	9.84
APPROVALS		DATE	
DESIGNER	SNS		
CHECKED			
MECH. ENG.			
ELEC. ENG.			
MFG. ENG.			
MATERIALS			
		<b>MOUNTING MODULE, OVAL REMOTE HEAD</b>	
Project: CR-1292		Date Created: 4-1-96	
SIZE	DWG. NO.	REV.	
B	A9895	C	
SCALE 1:2		PREPARED PER ASME 14.100M-1998 / ASME Y14.1-1995	
		SHEET 1 OF 1	

NON DISCLOSURE AGREEMENT  
 THIS DRAWING AND THE DESIGN IT DISCLOSES ARE THE PRIVATE PROPERTY OF ECCO AND IS ISSUED IN CONFIDENCE FOR ENGINEERING INFORMATION ONLY. THE DRAWING AND / OR DESIGN MAY NOT BE USED, COPIED, REPRODUCED, OR OTHERWISE DISCLOSED IN PART OR AS A WHOLE TO OUTSIDERS OR USED FOR ANY OTHER PURPOSE WITHOUT THE PRIOR WRITTEN CONSENT OF ECCO. THE DRAWING IS SUBJECT TO RECALL AT ANY TIME. YOUR POSSESSION OF THIS DOCUMENT CONSTITUTES ACCEPTANCE OF THESE TERMS. © 2002 ECCO

